138 BONITA AVE PIEDMONT, CA 94611







As Built Render Floor Plans.


All measurements are approximate. While deemed reliable, no information on these floor plans should be relied upon without independent verification.

138 BONITA AVE PIEDMONT, CA 94611





* Estimated Total Finished & Unfinished Square Footage: 7,376 SQ FT

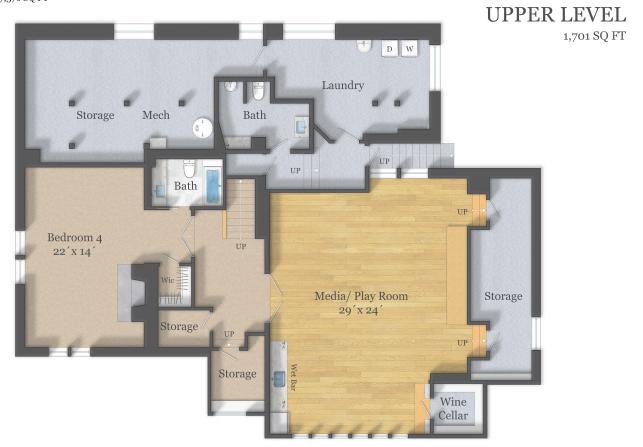

LOWER LEVEL

1,543 SQ FT

Email: jstrauch@grubbco.com